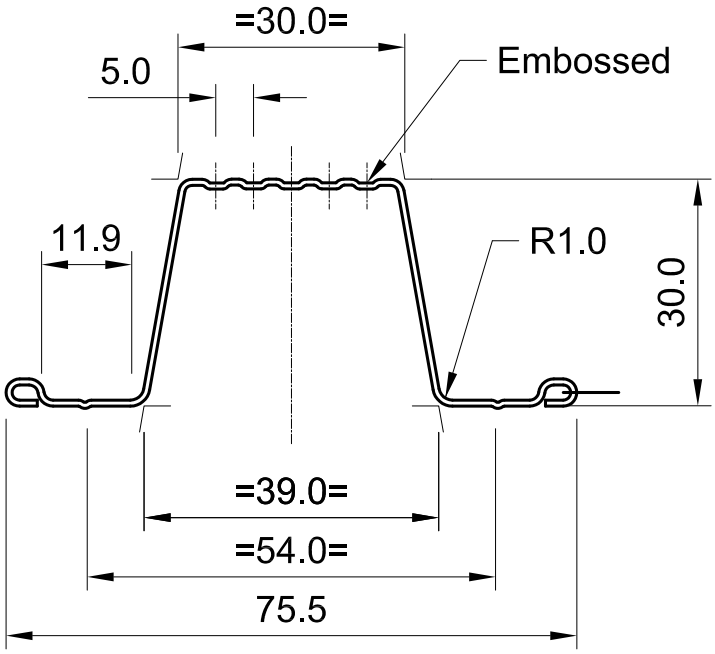



Strip Width = 133.0mm

N

| ISSUE | NOTES | DATE |
|---|---|---|
| A | AS BUILT | 13NOV14 |

TOLERANCES

XX = ± 1.0
XX.X = ± 0.1
XX.XX = ± 0.03

STANDARD TOLERANCES UNLESS OTHERWISE STATED

TITLE: DS30x0.55mm Ceiling batten

MATERIAL: 0.55mm G250 Z275

FINISH: Galv

DRAWN: Anton Mucalo 31/05/13

CHECKED

APPROVED


ALL DIMENSIONS ARE IN mm. - UNLESS OTHERWISE STATED. DO NOT SCALE - IF IN DOUBT, ASK.

SCALE

Rollforming SERVICES LIMITED
16b Ormiston Road, East Tamaki, Auckland.
Phone: 09 271 6834 | Fax: 09 271 6835
Email: sales@rollforming.co.nz
www.rollforming.co.nz
Copyright Rollforming Services LTD ©

DWG. No. DS30x0.55mm Ceiling Batten

A4

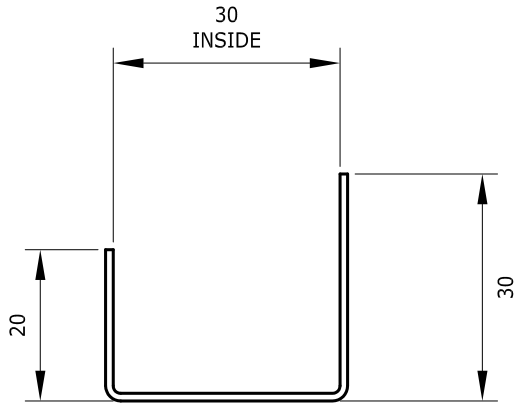



STRIP WIDTH 80mm

A

| ISSUE | NOTES | DATE |
|---|---|---|

| | | | | |
|---|---|---|---|---|
| TOLERANCES<br><br>XX = ± 1.0<br>XX.X = ± 0.1<br>XX.XX = ± 0.03 | TITLE: PC30x0.55 Perimeter Channel<br>MATERIAL: 80x0.55mm G250 Z275<br>FINISH: Galv. | | | Rollforming SERVICES LIMITED<br>16b Ormiston Road, East Tamaki, Auckland.<br>Phone: 09 271 6834 \| Fax: 09 271 6835<br>Email: sales@rollforming.co.nz<br>www.rollforming.co.nz<br>Copyright Rollforming Services LTD © |
| STANDARD TOLERANCES UNLESS OTHERWISE STATED | DRAWN: DS | 21NOV14 | ALL DIMENSIONS ARE IN mm. - UNLESS OTHERWISE STATED. DO NOT SCALE - IF IN DOUBT, ASK. | DWG. No. PROF 268B |
| | CHECKED | | | A4 |
| | APPROVED | | SCALE: N.T.S. | |

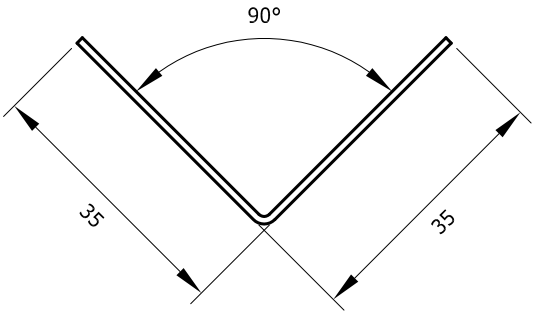


A

| ISSUE | NOTES | DATE |
|---|---|---|

TOLERANCES

XX = ± 1.0
XX.X = ± 0.1
XX.XX = ± 0.03

TITLE: ED35x0.55mm EasyDwang Angle

MATERIAL: 70x0.55 G250 Z275

FINISH: Galv.

DRAWN: DS — 21NOV14

CHECKED:

APPROVED:

ALL DIMENSIONS ARE IN mm. - UNLESS OTHERWISE STATED. DO NOT SCALE - IF IN DOUBT, ASK.


SCALE: N.T.S.

STANDARD TOLERANCES UNLESS OTHERWISE STATED

Rollforming SERVICES LIMITED
16b Ormiston Road, East Tamaki, Auckland.
Phone: 09 271 6834 | Fax: 09 271 6835
Email: sales@rollforming.co.nz
www.rollforming.co.nz
Copyright Rollforming Services LTD ©

DWG. No. PROF257C

A4

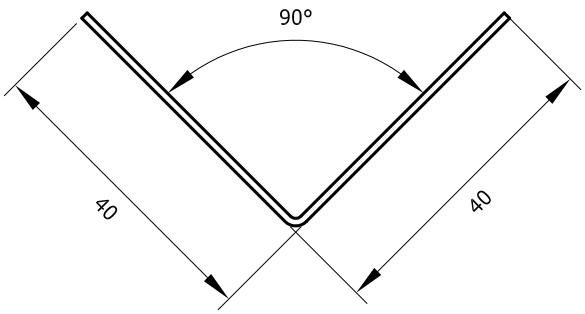


A

| ISSUE | NOTES | DATE |
|---|---|---|

TOLERANCES

XX = ± 1.0
XX.X = ± 0.1
XX.XX = ± 0.03

TITLE: ED40x0.75mm EasyDwang Angle

MATERIAL: 80x0.75 G250 Z275

FINISH: Galv.


Rollforming SERVICES LIMITED
16b Ormiston Road, East Tamaki, Auckland.
Phone: 09 271 6834 | Fax: 09 271 6835
Email: sales@rollforming.co.nz
www.rollforming.co.nz
Copyright Rollforming Services LTD ©

STANDARD TOLERANCES UNLESS OTHERWISE STATED

| | | | |
|---|---|---|---|
| DRAWN | DS | 21NOV14 | ALL DIMENSIONS ARE IN mm. - UNLESS OTHERWISE STATED. DO NOT SCALE - IF IN DOUBT, ASK. |
| CHECKED | | | |
| APPROVED | | | SCALE N.T.S. |

DWG. No. PROF257B


A4

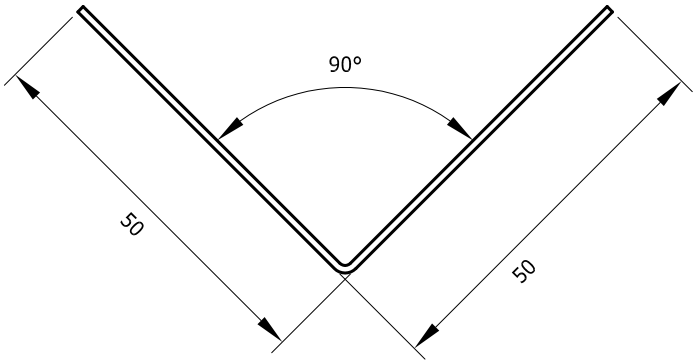



A

| ISSUE | NOTES | DATE |
|---|---|---|

| | | | |
|---|---|---|---|
| TOLERANCES<br><br>XX = ± 1.0<br>XX.X = ± 0.1<br>XX.XX = ± 0.03 | TITLE: ED50x0.55mm EasyDwang Angle<br>MATERIAL: 100x0.55 G250 Z275<br>FINISH: Galv. | | Rollforming SERVICES LIMITED<br>16b Ormiston Road, East Tamaki, Auckland.<br>Phone: 09 271 6834 \| Fax: 09 271 6835<br>Email: sales@rollforming.co.nz<br>www.rollforming.co.nz<br>Copyright Rollforming Services LTD © |
| STANDARD TOLERANCES UNLESS OTHERWISE STATED | DRAWN: DS<br>CHECKED:<br>APPROVED: | 21NOV14 | ALL DIMENSIONS ARE IN mm. - UNLESS OTHERWISE STATED. DO NOT SCALE - IF IN DOUBT, ASK.<br>SCALE: N.T.S. | DWG. No.<br>A4<br>PROF257D |

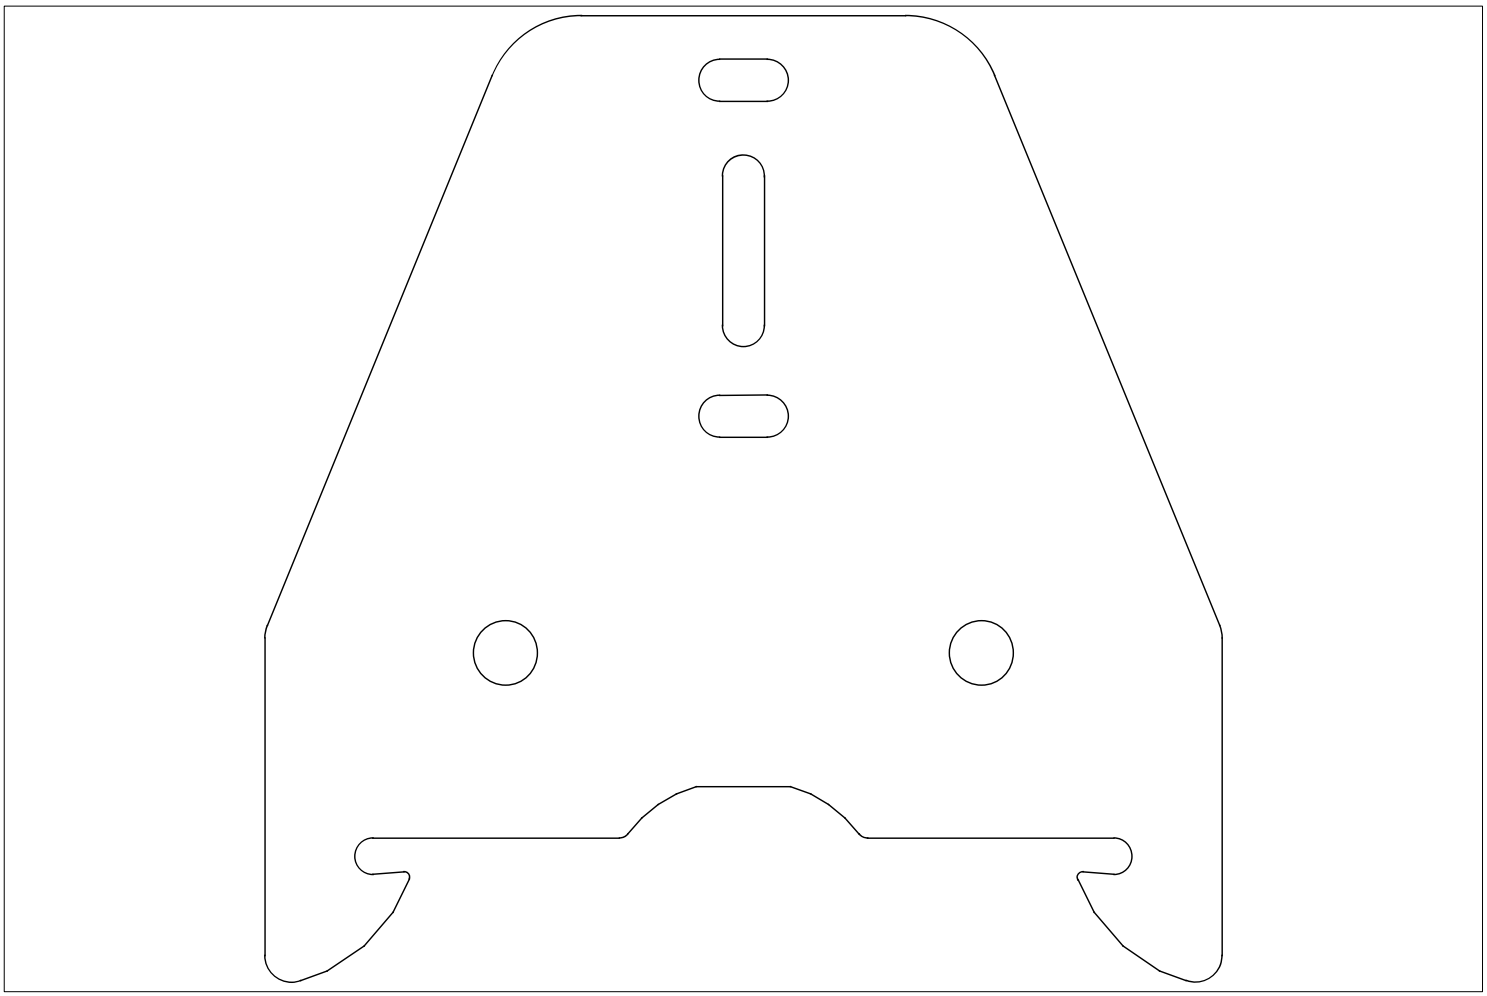

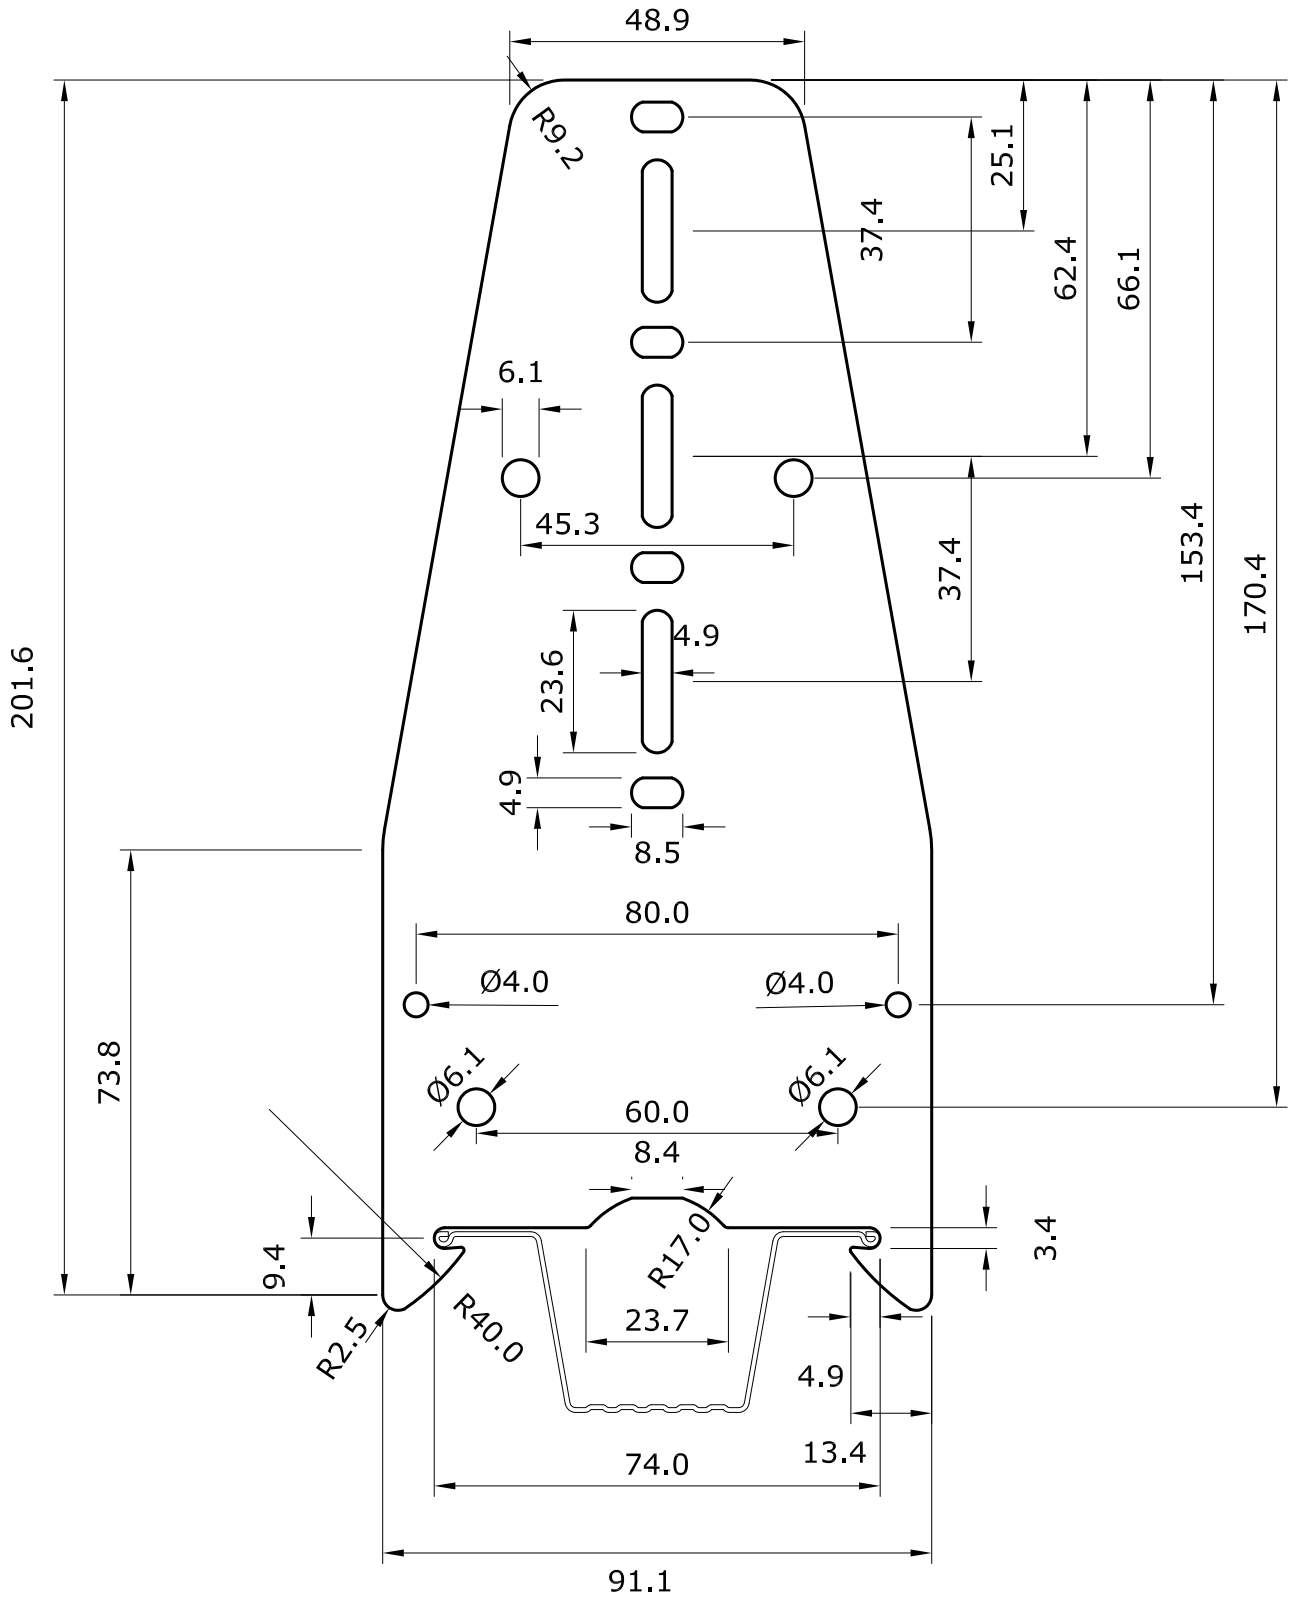


| ISSUE | NOTES | DATE |
|---|---|---|
| B | EXTRA HOLES ADDED | 17FEB16 |
| A | FOR REVIEW | 23MAR15 |

TOLERANCES

XX = ± 1.0
XX.X = ± 0.1
XX.XX = ± 0.03

STANDARD TOLERANCES UNLESS OTHERWISE STATED

TITLE: EBR204x1.0mm Batten Bracket

MATERIAL: 1.0 thk B.M.T.

FINISH: G250 Z275

DRAWN: Trent Cornwall 18/10/13

CHECKED:

APPROVED:

ALL DIMENSIONS ARE IN mm. - UNLESS OTHERWISE STATED. DO NOT SCALE - IF IN DOUBT, ASK.


SCALE

Rollforming SERVICES LIMITED
16b Ormiston Road, East Tamaki, Auckland.
Phone: 09 271 6834 | Fax: 09 271 6835
Email: sales@rollforming.co.nz
www.rollforming.co.nz
Copyright Rollforming Services LTD ©

DWG. No. EBR204x1.0mm Batten Bracket

Rev B

A4

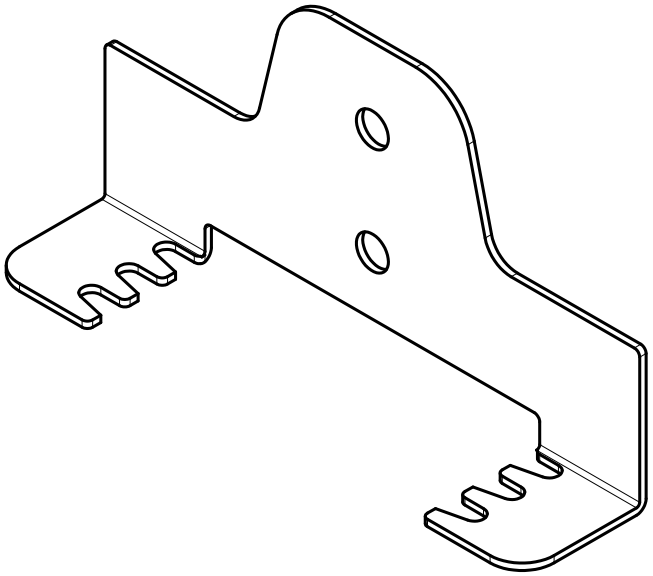

| ISSUE | NOTES | DATE |
|---|---|---|
| B | MATERIAL CHANGED TO 1.2mm | 24FEB16 |
| A | TOP HAT CLIP SIZE AMENDED | 12NOV14 |

N

TOLERANCES

XX = ± 1.0
XX.X = ± 0.1
XX.XX = ± 0.03

STANDARD TOLERANCES UNLESS OTHERWISE STATED

TITLE: WBRx1.4mm Adj Wall Bracket (Iso)

MATERIAL: 1.4mm G250 Z80

FINISH: Galv

DRAWN: D.S. 7Oct14

CHECKED:


APPROVED:


ALL DIMENSIONS ARE IN mm. - UNLESS OTHERWISE STATED. DO NOT SCALE - IF IN DOUBT, ASK.

SCALE: A4

Rollforming SERVICES LIMITED
16b Ormiston Road, East Tamaki, Auckland.
Phone: 09 271 6834 | Fax: 09 271 6835
Email: sales@rollforming.co.nz
www.rollforming.co.nz
Copyright Rollforming Services LTD ©

DWG. No. WBRx1.4mm Adj Wall Bracket

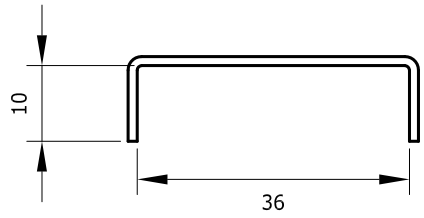

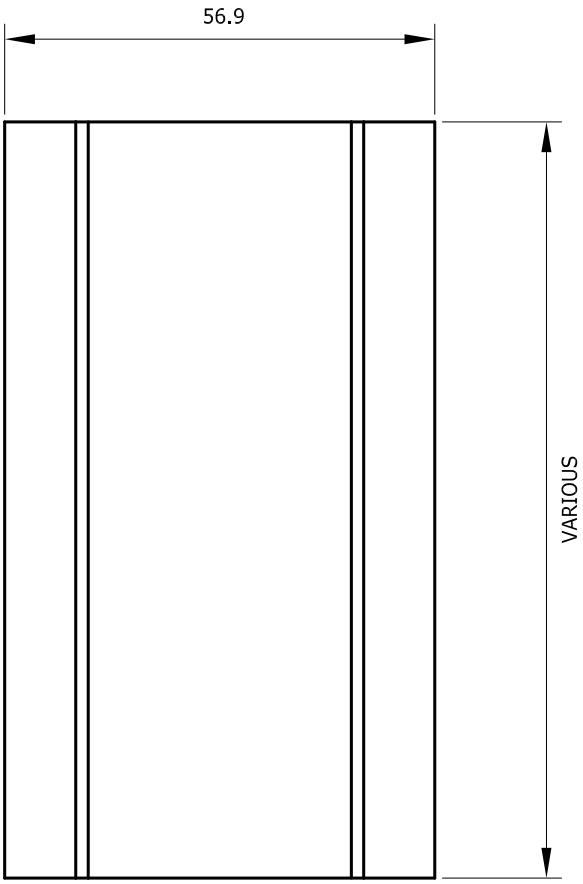
UNBENDED

N

| ISSUE | NOTES | DATE |
|---|---|---|

TOLERANCES

XX = ± 1.0
XX.X = ± 0.1
XX.XX = ± 0.03

STANDARD TOLERANCES UNLESS OTHERWISE STATED

TITLE: SB38x1.2mm Strong Back

MATERIAL: 1.2mm G250 Z275

FINISH: Galv

DRAWN: D.S. 7OCT15

CHECKED


APPROVED

ALL DIMENSIONS ARE IN mm. - UNLESS OTHERWISE STATED. DO NOT SCALE - IF IN DOUBT, ASK.


SCALE: A4


Rollforming SERVICES LIMITED
16b Ormiston Road, East Tamaki, Auckland.
Phone: 09 271 6834 | Fax: 09 271 6835
Email: sales@rollforming.co.nz
www.rollforming.co.nz
Copyright Rollforming Services LTD ©

DWG. No. SB38x1.2mm Strong Back

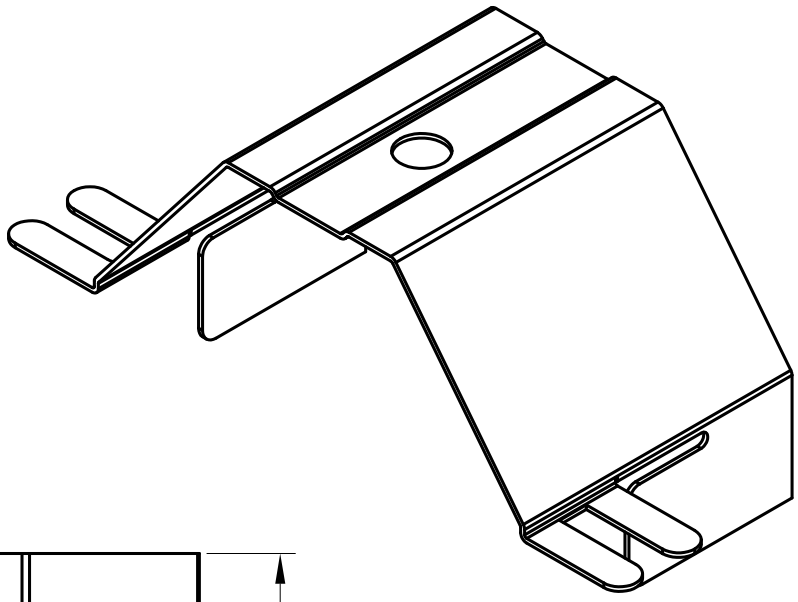

FINGERS SHOWN IN FOLDED POSITION

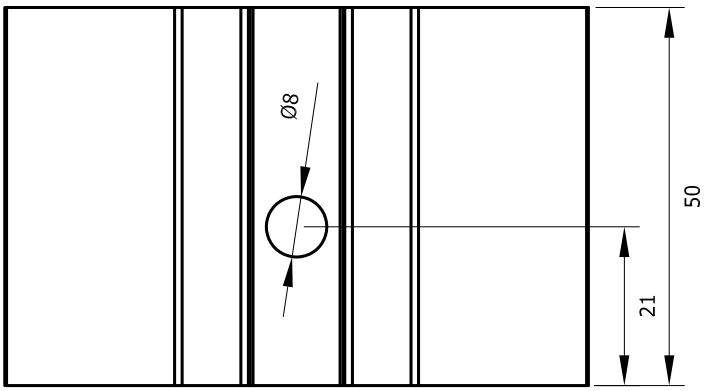

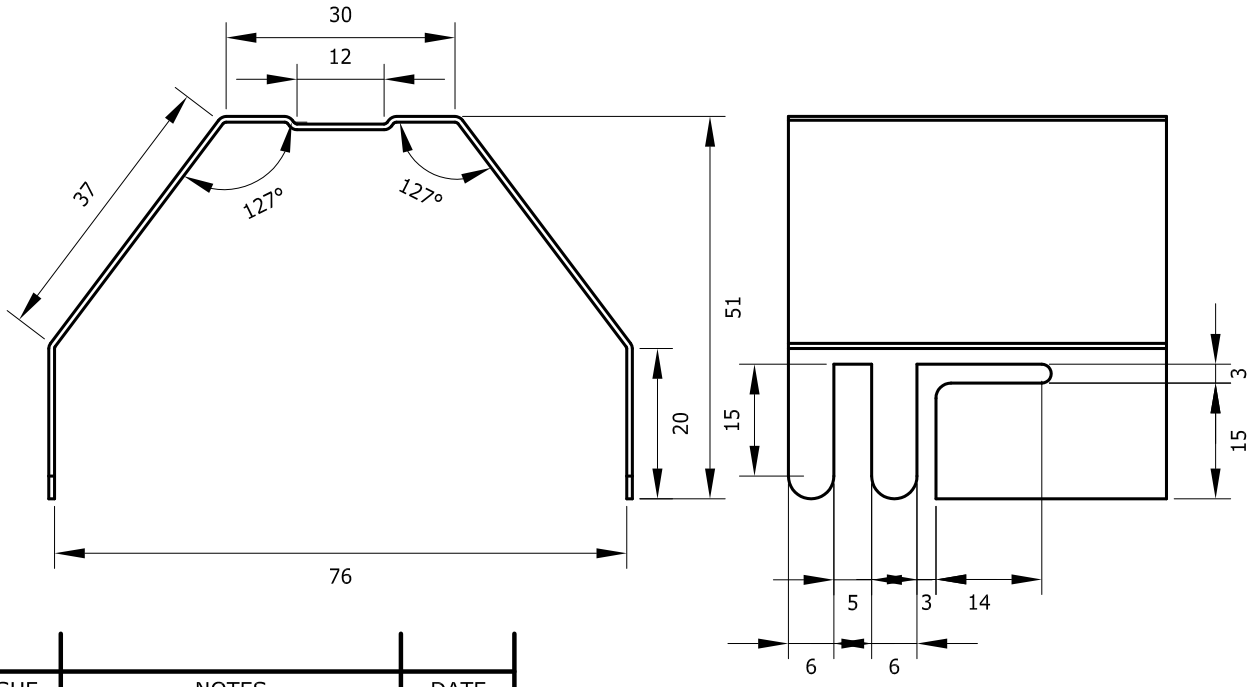
N

| ISSUE | NOTES | DATE |
|---|---|---|

TOLERANCES

XX = ± 1.0
XX.X = ± 0.1
XX.XX = ± 0.03

TITLE: SBBx0.75mm 30mm Strong Back Bracket

MATERIAL: 0.75mm G250 Z80

FINISH: Galv

DRAWN: D.S. 29Feb16

CHECKED:

APPROVED:

ALL DIMENSIONS ARE IN mm. - UNLESS OTHERWISE STATED. DO NOT SCALE - IF IN DOUBT, ASK.

SCALE

STANDARD TOLERANCES UNLESS OTHERWISE STATED

Rollforming SERVICES LIMITED
16b Ormiston Road, East Tamaki, Auckland.
Phone: 09 271 6834 | Fax: 09 271 6835
Email: sales@rollforming.co.nz
www.rollforming.co.nz
Copyright Rollforming Services LTD ©

DWG. No. SBBx0.75mm Strong Back Bracket

A4